DIAGRAM 'C'
Not to Scale

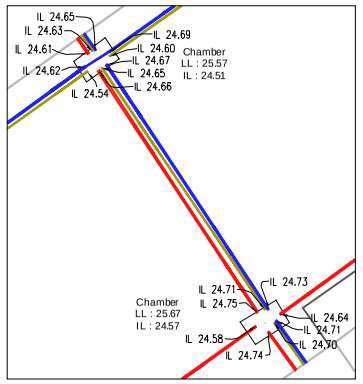


DIAGRAM 'B'
Not to Scale




DIAGRAM 'A'
Not to Scale




DIAGRAM 'D'
Not to Scale

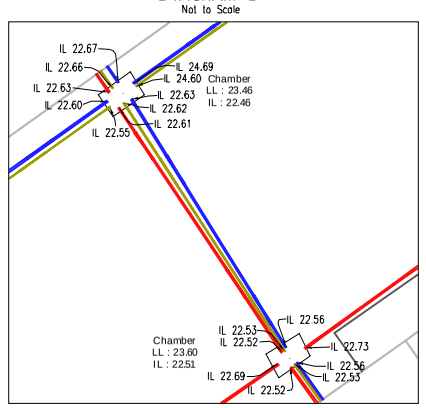


DIAGRAM 'E'
Not to Scale




DIAGRAM 'F'
Not to Scale




DIAGRAM 'H'
Not to Scale




DIAGRAM 'G'
Not to Scale




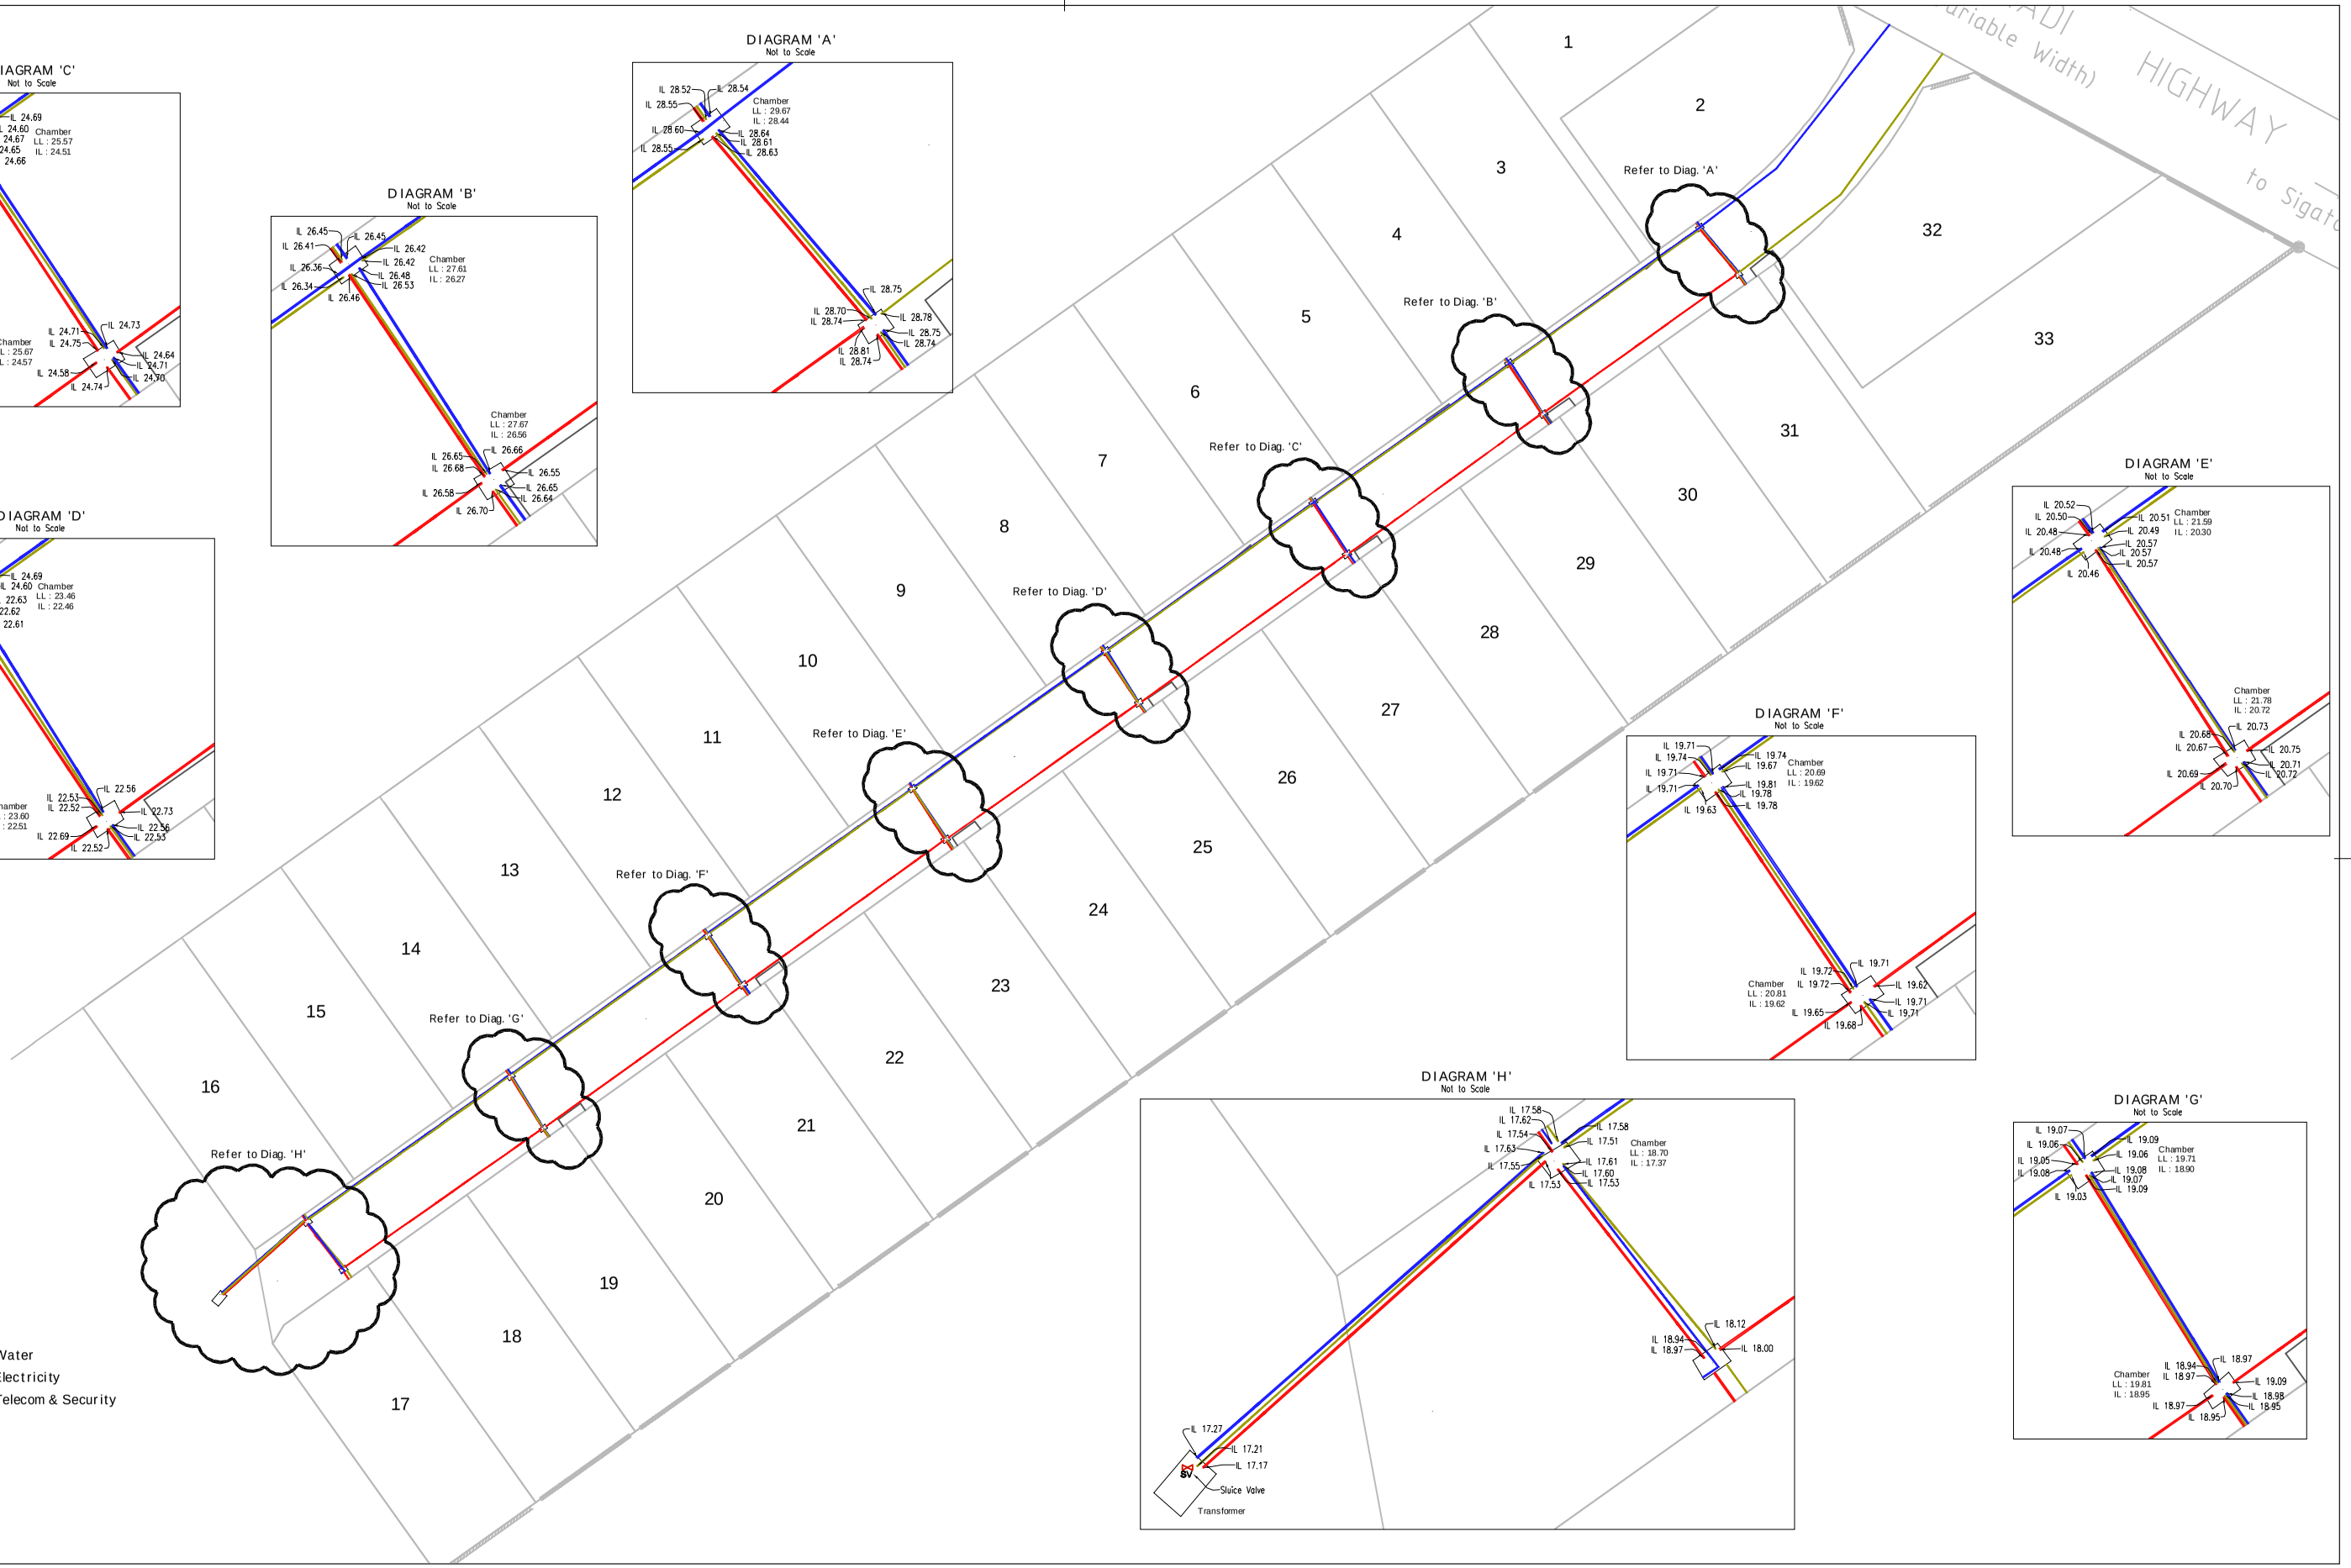


| Rev No | Revision note | Date | Signature Checked | Issued | No. | Name | Date |
|---|---|---|---|---|---|---|---|

**WOOD & JEPSEN CONSULTANTS**
CIVIL ENGINEERS SURVEYORS PLANNERS
POBox 1248 SUVA
10 HOLLAND ST. SUVA
FIJI
PH: (679) 311077
FAX: (679) 303361
E-MAIL: WOODJEPSEN@IS.COM.FJ

Client: A.G. JENNINGS & SONS LIMITED

Project: Electrical Reticulation
Seashell Estate, Malaqereqere,
SIGATOKA

Drawing Title: AS-BUILT PLAN

| Surveyed by | Drawn by | Scale(A1) | Field Bk | Computer # |
|---|---|---|---|---|
| JC | KT | 1:500 | | |
| Checked by | | Approved by – date | SC Ref:– | |
| RGJ | | RGJ_06/10/09 | | |
| W&J Ref. No: 6337 | | Edition 1 | Sheet 1 of 1 | |